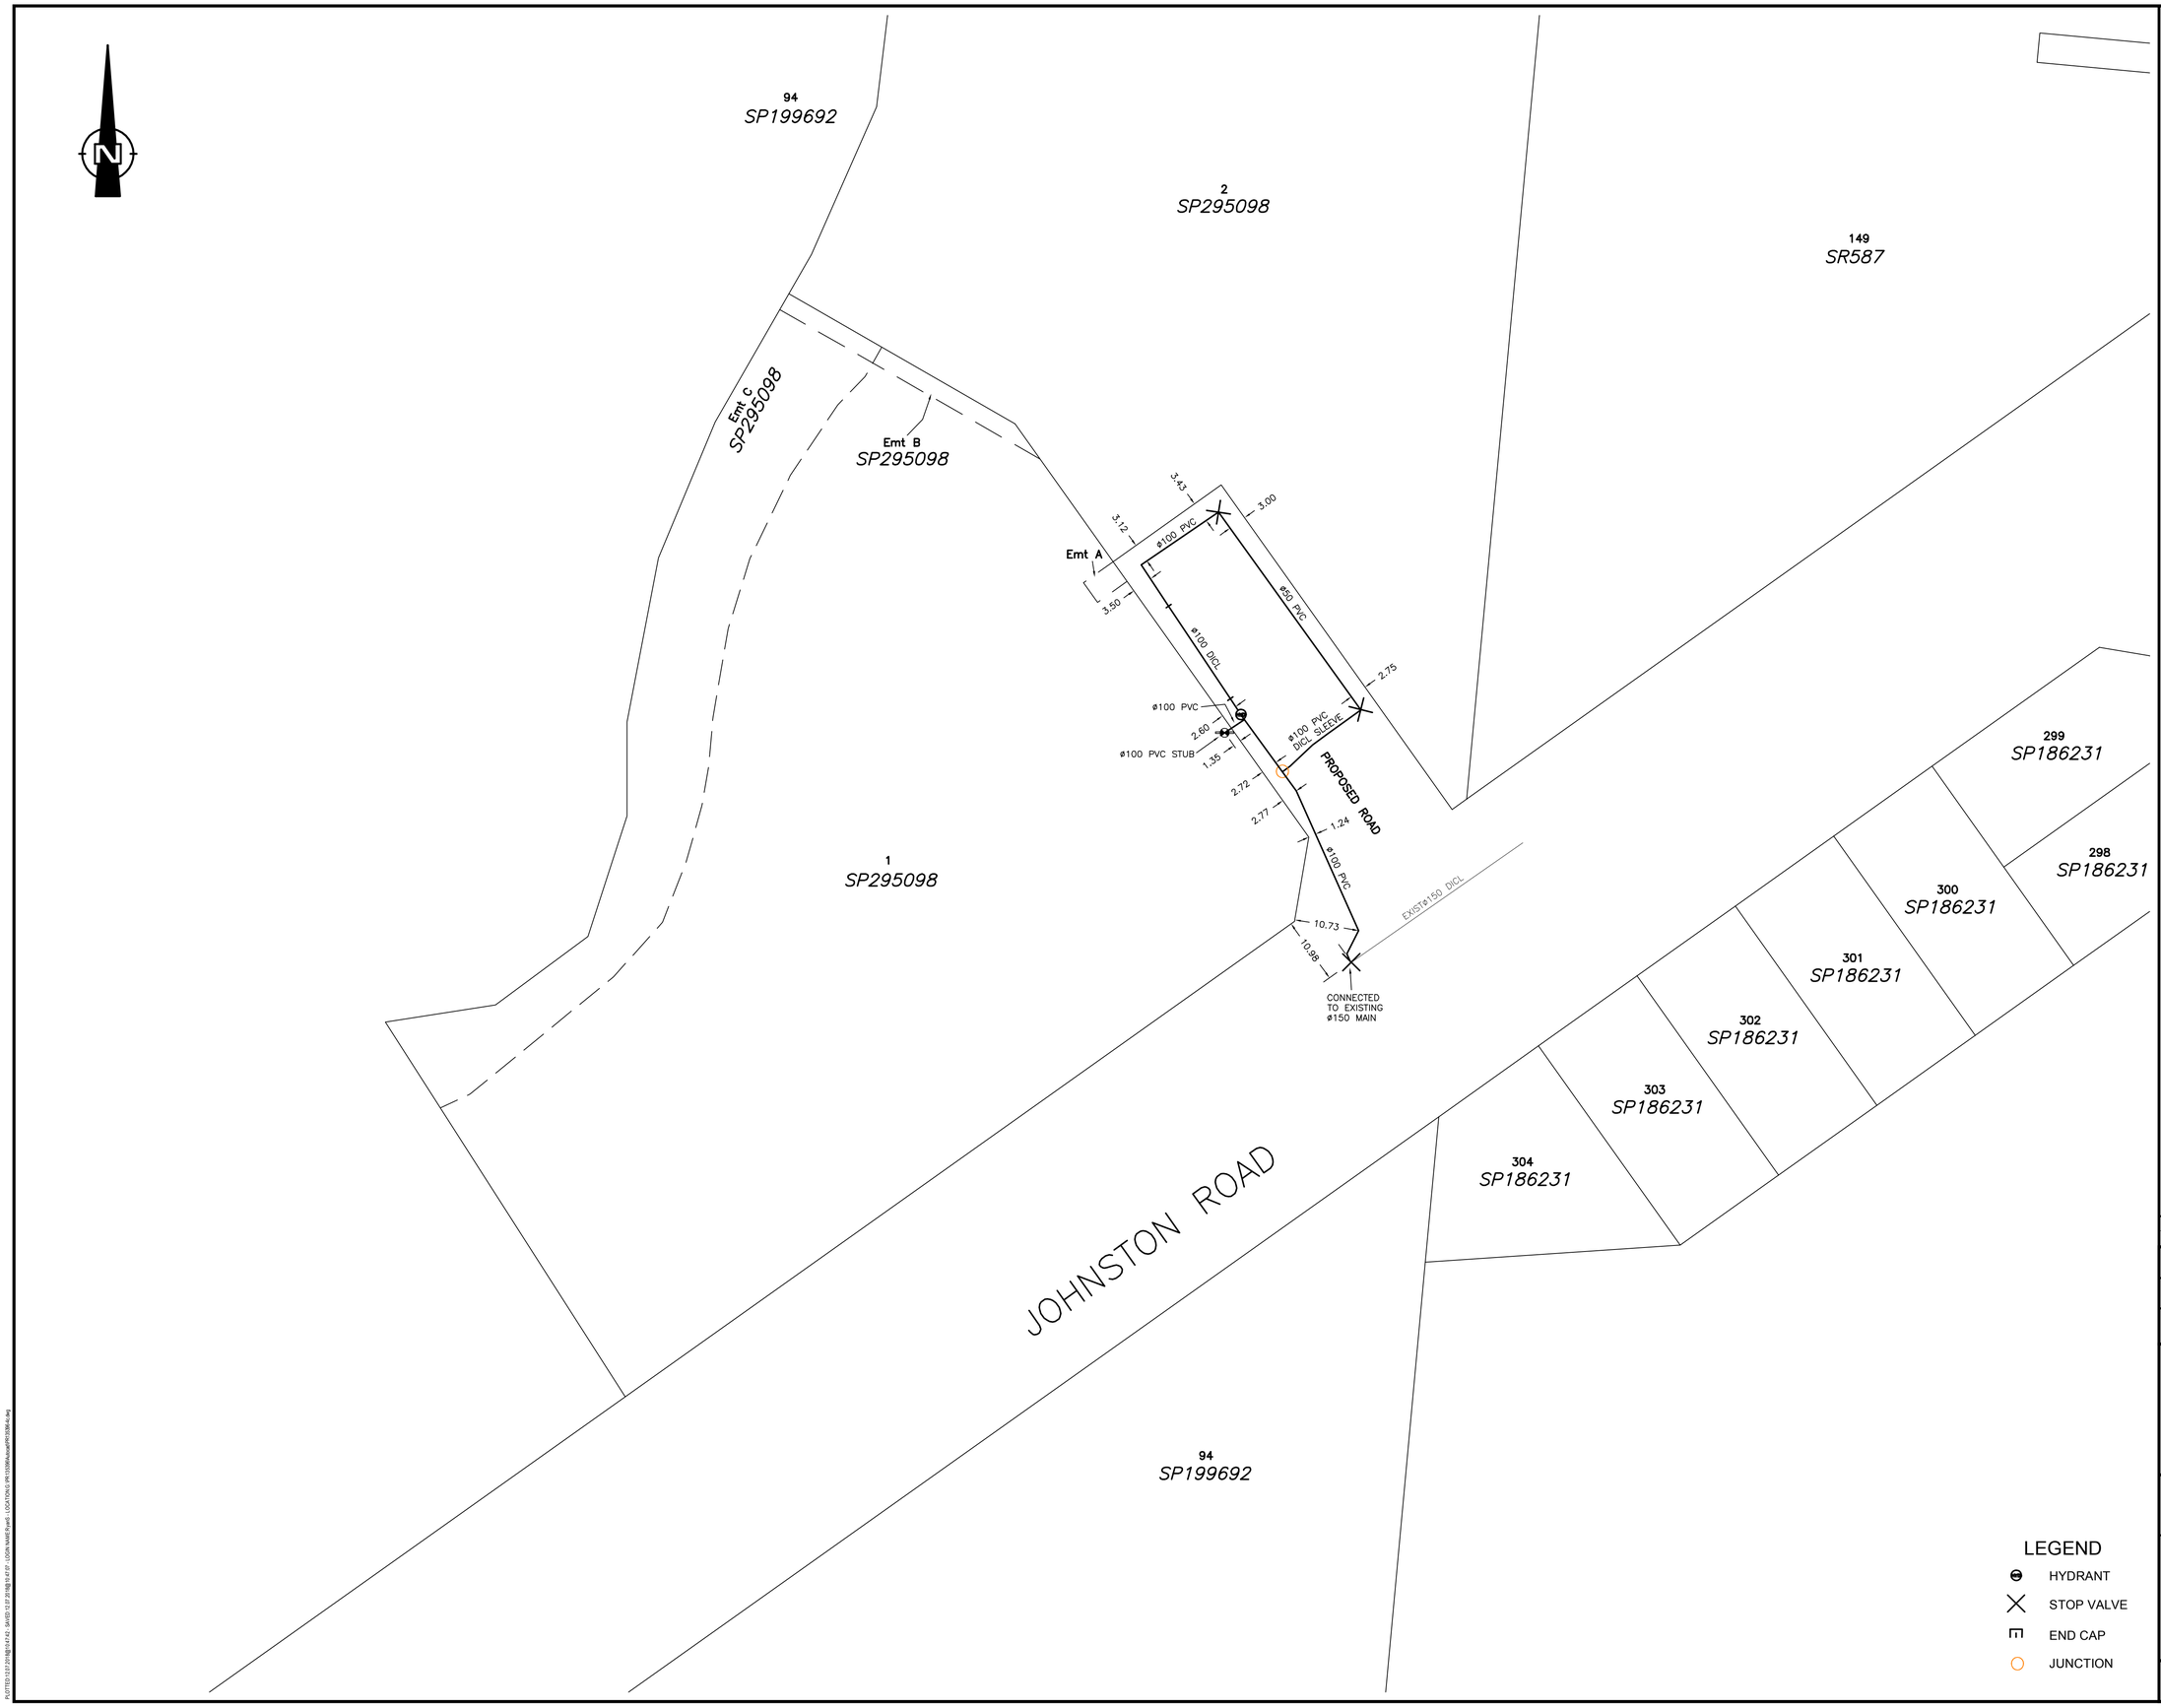

CERTIFICATION

RPS Australia East Pty Ltd (ACN 140 292 762), certifies that the locations of the water infrastructure on this plan have been surveyed in accordance with the requirements of the FNQROC Development Manual and, to the best of our knowledge and subject to Qualifications Note below, are accurate.

ORIGINAL SIGNED
COPY SIGNED
AUTHORISED
DELEGATE

Authorised Person

Date

IMPORTANT NOTE

1. This plan was prepared for the sole purposes of the client for the specific purpose of recording the infrastructure for the Douglas Shire Council. This plan is strictly limited to the Purpose and does not apply directly or indirectly and will not be used for any other application, purpose, use or matter. The plan is presented without the assumption of a duty of care to any other person (other than the Client) ("Third Party") and may not be relied on by Third Party.

2. RPS Australia East Pty Ltd will not be liable (in negligence or otherwise) for any direct or indirect loss, damage, liability or claim arising out of or incidental to;
   A. Third Party publishing, using or relying on the plan;
   B. RPS Australia East Pty Ltd relying on information provided to it by the Client or a Third Party where the information is incorrect, incomplete, inaccurate, out-of-date or unreasonable;
   C. any inaccuracies or other faults with information or data sourced from a Third Party;
   D. RPS Australia East Pty Ltd relying on surface indicators that are incorrect or inaccurate;
   E. the Client or any Third Party not verifying information in this plan where recommended by RPS Australia East Pty Ltd;
   F. lodgement of this plan with any local authority against the recommendation of RPS Australia East Pty Ltd;
   G. the accuracy, reliability, suitability or completeness of any approximations or estimates made or referred to by RPS Australia East Pty Ltd in this plan.

3. Without limiting paragraph 1 or 2 above, this plan may not be copied, distributed, or reproduced by any process unless this note is clearly displayed on the plan.

4. Scale shown is correct for the original plan and any copies of this plan should be verified by checking against the bar scale.

5. Stop valves, hydrants and other visible surface indicators have been located by survey. Other information has been obtained from design and construction information [provided by Third Parties] and should be checked before use.

6. The positions of some services shown on this plan have been exaggerated for drawing clarity purposes. Dimensions shown take precedence over scaled position.

NOTES

Level Datum: AHD

Origin of Levels: PSM 100497
RL 10.110

Meridian: MGA zone 55 vide PR120568-1
PSM 96532-100497
E 325785.784
N 8179385.049

Origin of Coordinates: PSM 100497
E: 325992.920
N: 8179376.360

0 5 10 15 20 25
metres

SCALE 1:500 IS APPLICABLE ONLY TO THE ORIGINAL SHEET SIZE. (A1)
(1:1000 @ A3)

AMENDMENTS
A: RMS: ADDED NEW DETAIL

PROJECT MANAGER	SURVEYED
D. PINKHAM	
COMPILED: RMS	CAD REF: PR135396-4c.DWG
SHEET SIZE: A1 — SHEET 1 OF SHEETS 1	135396-1 As-constructed access.mpc XR PR135396-1c.DWG

RPS Australia East Pty Ltd
ACN 140 292 762

10/9 Pioneer Cl
CRAIGLIE QLD 4877
PO Box 355
MOSSMAN QLD 4873

T +61 7 4098 1148
F +61 7 4098 1814
W rpsgroup.com.au

© COPYRIGHT PROTECTS THIS PLAN
Unauthorised reproduction or amendment not permitted. Please contact the author.

NORTHERN CIVIL

MOSSMAN AGED CARE
EXTERNAL WORKS
AS-CONSTRUCTED
WATER
JOHNSTON ROAD

SCALE	DATE	DRAWING NO.	ISSUE
1:500	20/09/2017	PR135396-4	C